


A

B

C

D

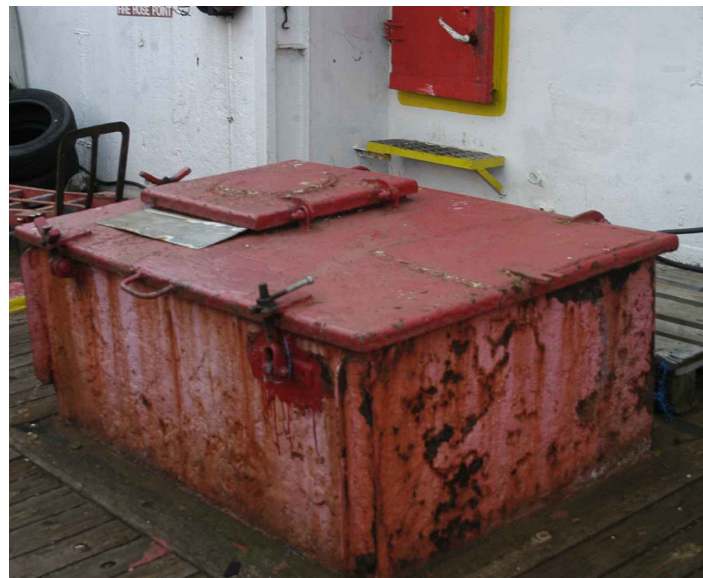

REVISIONS		NOTES
RD	GJ	RECORD DRAWING
Rev	Date	By Description

Copyright Notice
 This drawing is subject to Copyright © Ross Revenge Plans (2015-2017) - Reg No 284707913 and may not be altered, reproduced or used other than for the purpose which it is issued.
Terms of Use
 Ross Revenge Plans utilise Digital Rights Management (DRM) on all products. Use of this file denotes the recipient's acceptance of our DRM policies. Copy available on request.



PROJECT
ROSS REVENGE

DRAWING TITLE
MAIN DECK PLAN LAYOUT (2)

Date: FEB-2016	Scale: 1:50
Drawn: GJ	Eng: GJ
File Ref:	Checked By:
Sheet Size: A3	
Drawing No: 319-RR-MP-026	
RECORD DRAWING	

A3