


ROSS REVENGE CURRENT TRANSMITTER MAST - INSTALLED 2010 - 2012


SECTION NUMBER	SECTION HEIGHT (METRES)	SECTION WEIGHT (KG)	BASE WIDTH (METRES)	SECTION NUMBER
6	3.05	51	0.5	6
5	3.05	51	0.5	5
4	6.10	218	0.95	4
3	6.10	297	1.40	3
2	6.10	369	1.85	2
1	6.10	471	2.286	1

30500

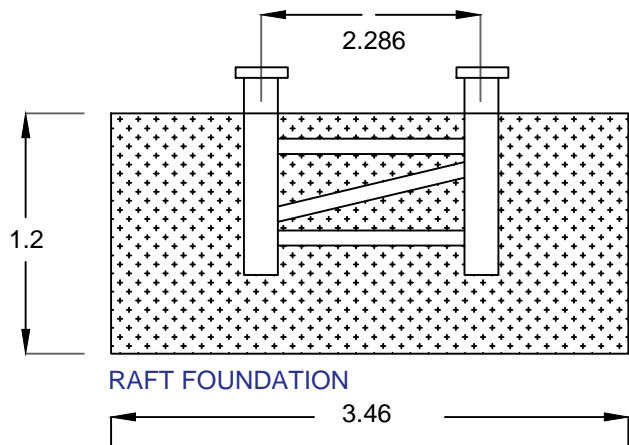

ALL FLANGES ARE 3 POINT FIXINGS
ALL BOLTS/NUTS 8MM

TUBE LEGS 76.1 x 5MM
BRACINGS 60x60x6

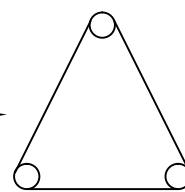

REV	DATE	DESCRIPTION



ROSS REVENGE

TX MAST DIMENSIONS

Drawn: G	Eng: G	Checked: B
Proj: 319-RR-MP-035	Sheet: A3	
RECORD DRAWING		