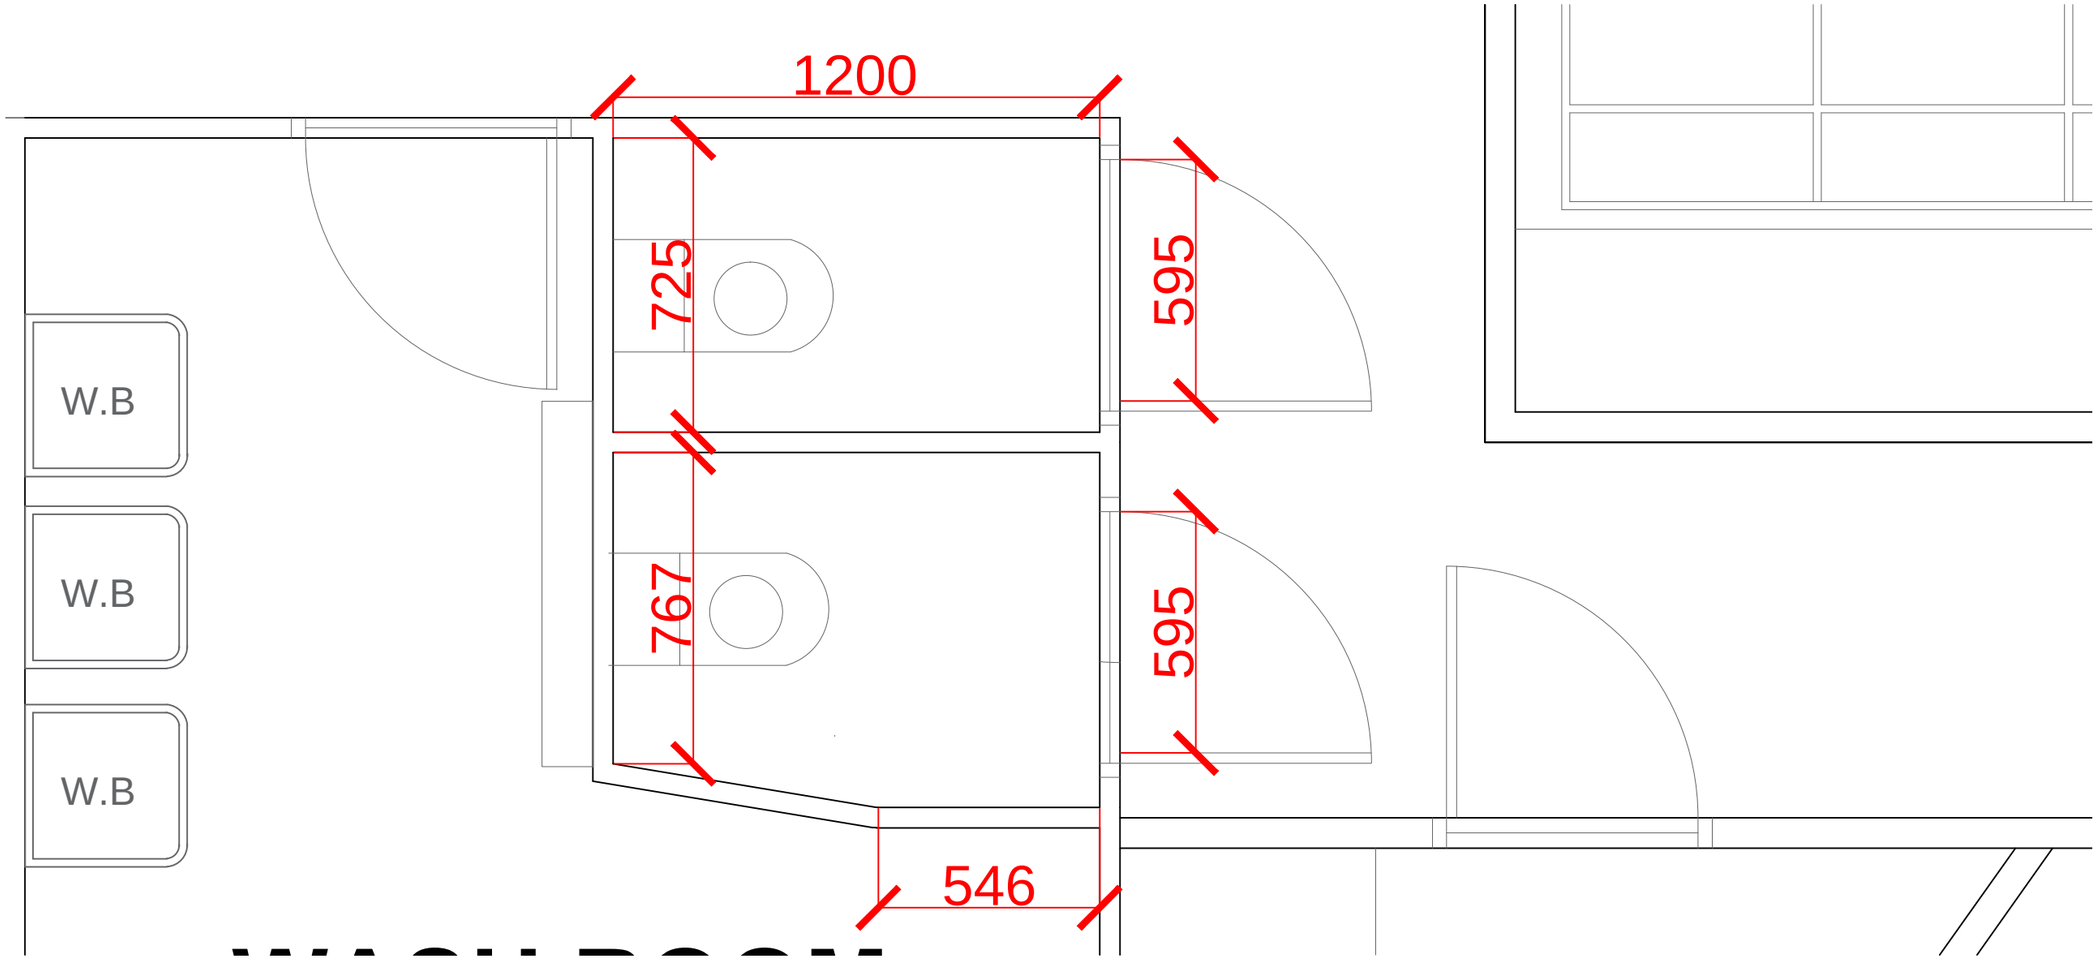

A

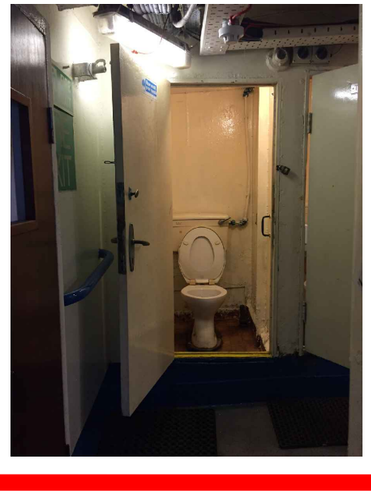

D

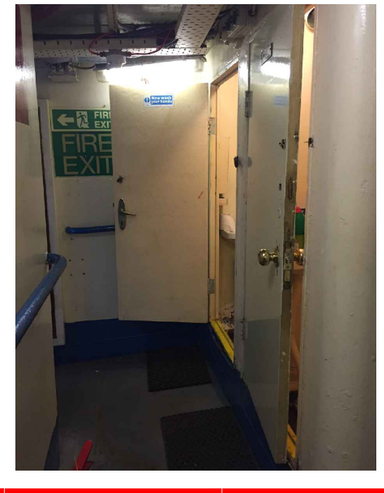

REVISIONS				NOTES					
				Copyright Notice This drawing is subject to Copyright © Ross Revenge Plans (2015-2017) - Reg No 284707913 and may not be altered, reproduced or used other than for the purpose which it is issued. Terms of Use Ross Revenge Plans utilise Digital Rights Management (DRM) on all products. Use of this file deems the recipients acceptance of our DRM policies. Copy available on request.				
RD		GJ	RECORD DRAWING						
Rev	Date	By	Description						

		PROJECT	DRAWING TITLE	
A3	RRP	ROSS REVENGE	MAIN DECK WC'S PLAN LAYOUT	Date: FEB-2016 Scale: 1:50 Drawn: GJ Eng: GJ Checked By: File Ref: Sheet Size: A3 Drawing No: 319-RR-MP-007 Status: RECORD DRAWING