




**MAIN DECK**

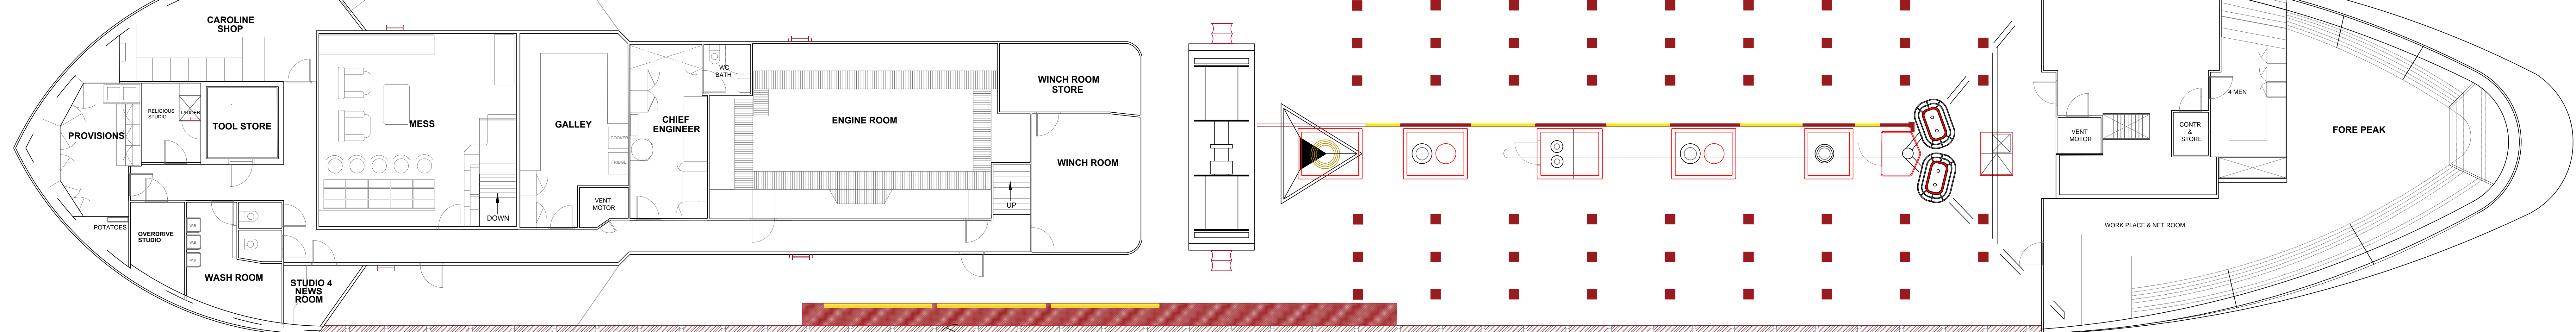

**HOLD**

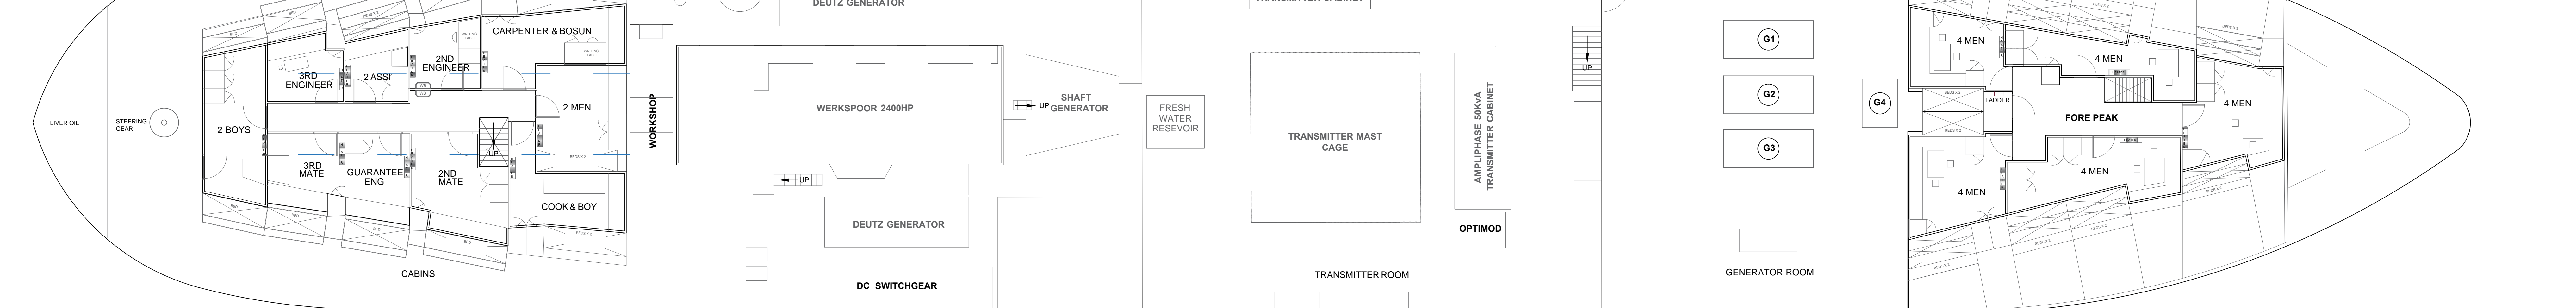

**SIDE ELEVATION 1989**

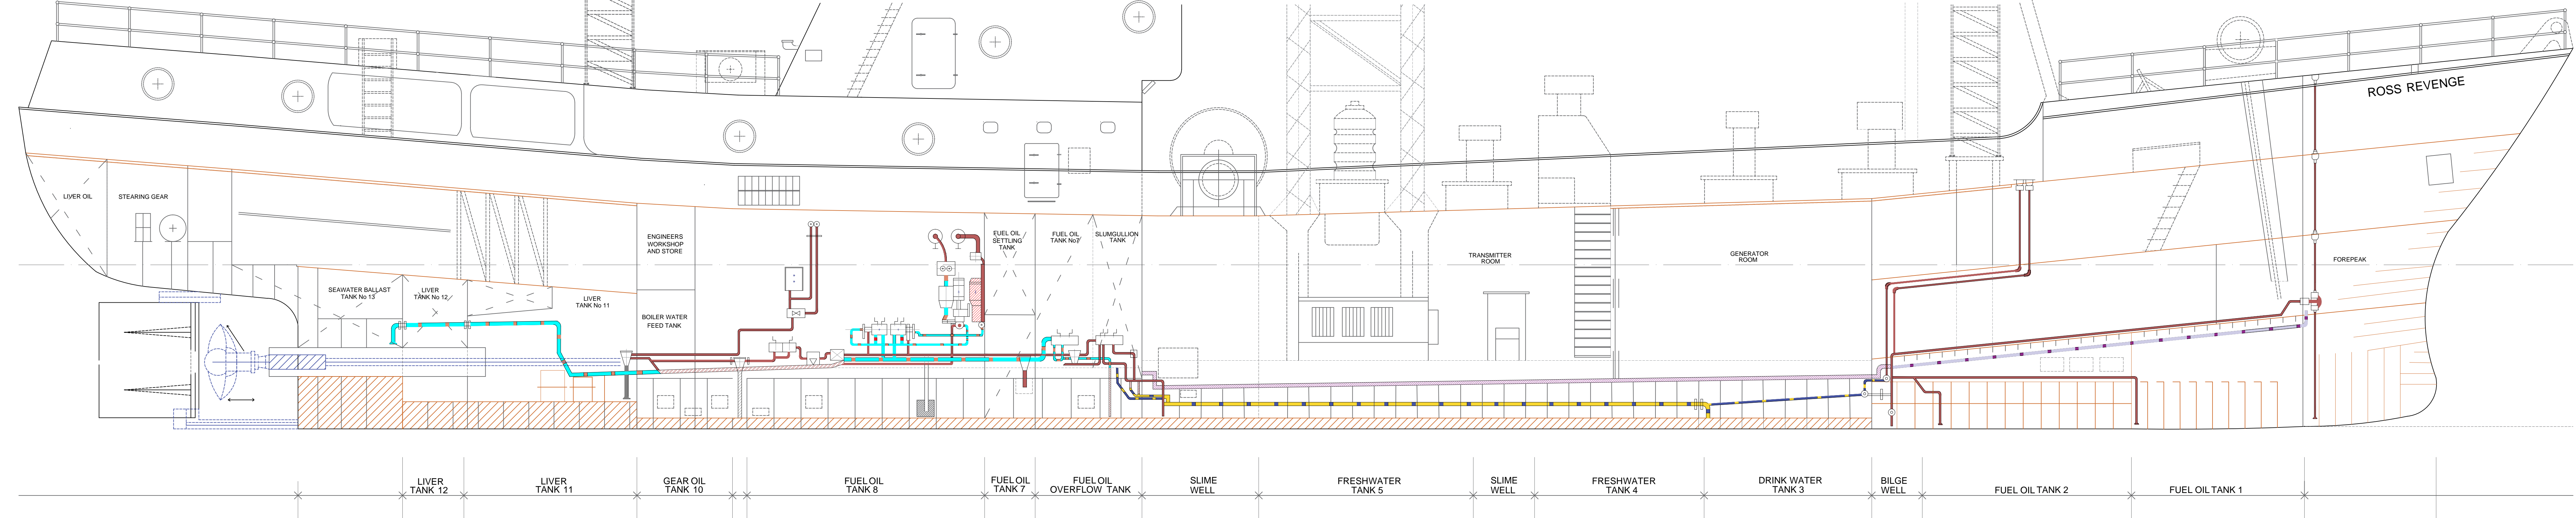

REV	DATE	BY	DESCRIPTION
RD		GJ	RECORD DRAWING

**NOTES**

Copyright Notice  
 This drawing is subject to Copyright © Ross Revenge Plans (2015-2017) - Reg No 284707913 and may not be altered, reproduced or used other than for the purpose which it is issued.

Terms of Use  
 Ross Revenge Plans utilise Digital Rights Management (DRM) on all products. Use of this file deems the recipients acceptance of our DRM policies. Copy available on request.

	<b>ROSS REVENGE</b>	<b>LOWER DECK GA</b>	Date: MAR 2016	Scale: 1:50
			Drawn: G JOHNSON	Checked By:
			File Ref:	Sheet Size: A0
			Drawing No: <b>558-RR-GA-001</b>	Status: RECORD DRAWING

A0